




CANTON BAY Woods Div #1  
LOT # 9

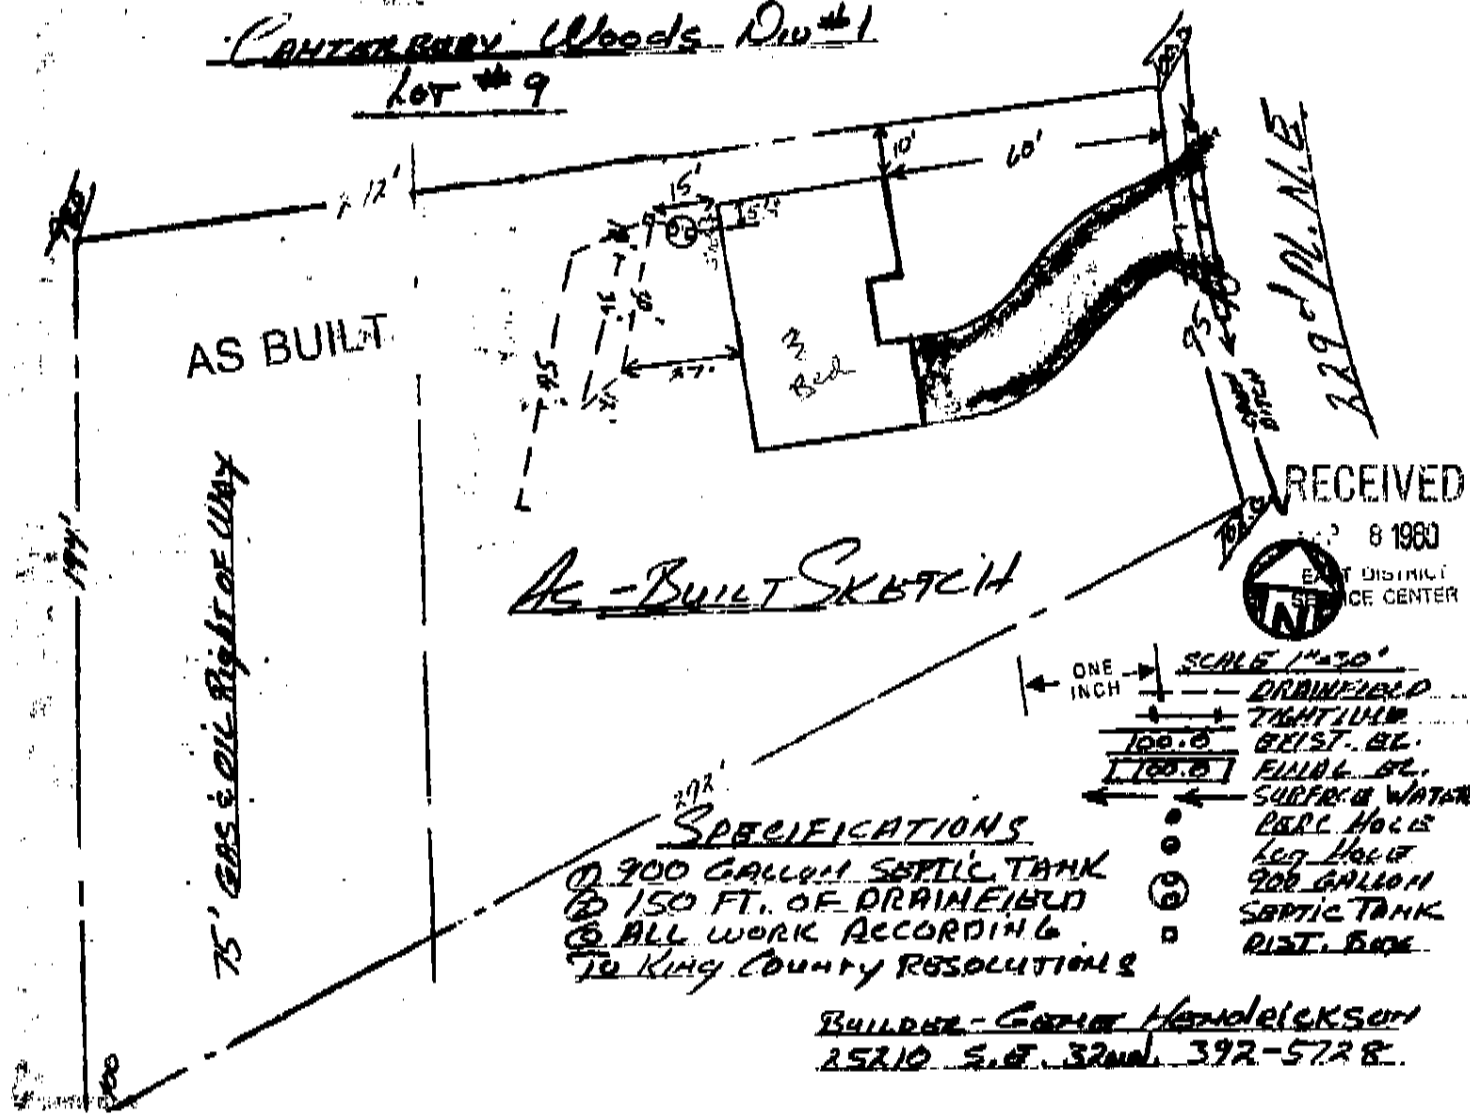

RECEIVED  
8 1980  
EAST DISTRICT  
SERVICE CENTER

AS-BUILT SKETCH

- ONE INCH → SCALE 1"=30'
- DRAINFIELD
  - TIGHTLINE
  - 100.0 BEST. BL.
  - 100.0 FINAL BL.
  - ← SURFACE WATER
  - PERC. HOLE
  - LOG HOLE
  - 900 GALLON SEPTIC TANK
  - DIST. BOX

SPECIFICATIONS

- ① 900 GALLON SEPTIC TANK
- ② 150 FT. OF DRAINFIELD
- ③ ALL WORK ACCORDING TO KING COUNTY RESOLUTIONS

BUILDER - Gordon Handeleksen  
25210 S.E. 32nd 392-5728